



August 9, 2017

Brian Dranzik,
Director of Transportation
Milwaukee County
Department of Transportation
10320 W. Watertown Plank Rd., 2nd Floor
Wauwatosa, WI 53226

Subject: CTH-Y (West Layton Avenue)
Request to Designate No Parking and Right Turn Only

Dear Mr. Dranzik,

The City of Greenfield requests permission to work with your department to designate a portion of CTH-Y (West Layton Avenue) "No Parking" and "Right Turn Only".


In 2016, a new signalized intersection was constructed at South 57th street. Greenfield would like to designate both sides of CTH-Y (West Layton Avenue) from South 60th Street to South 57th Street as "No Parking". We would also like to designate the eastbound approach to both 60th Street and 57th Street as "Right Turn Only". See attached exhibit.

Sincerely,

Jeff Katz, P.E.
City Engineer
Director of Neighborhood Services
City of Greenfield

Enclosures

CC Andrea Weddle-Henning
Daniel Murphy

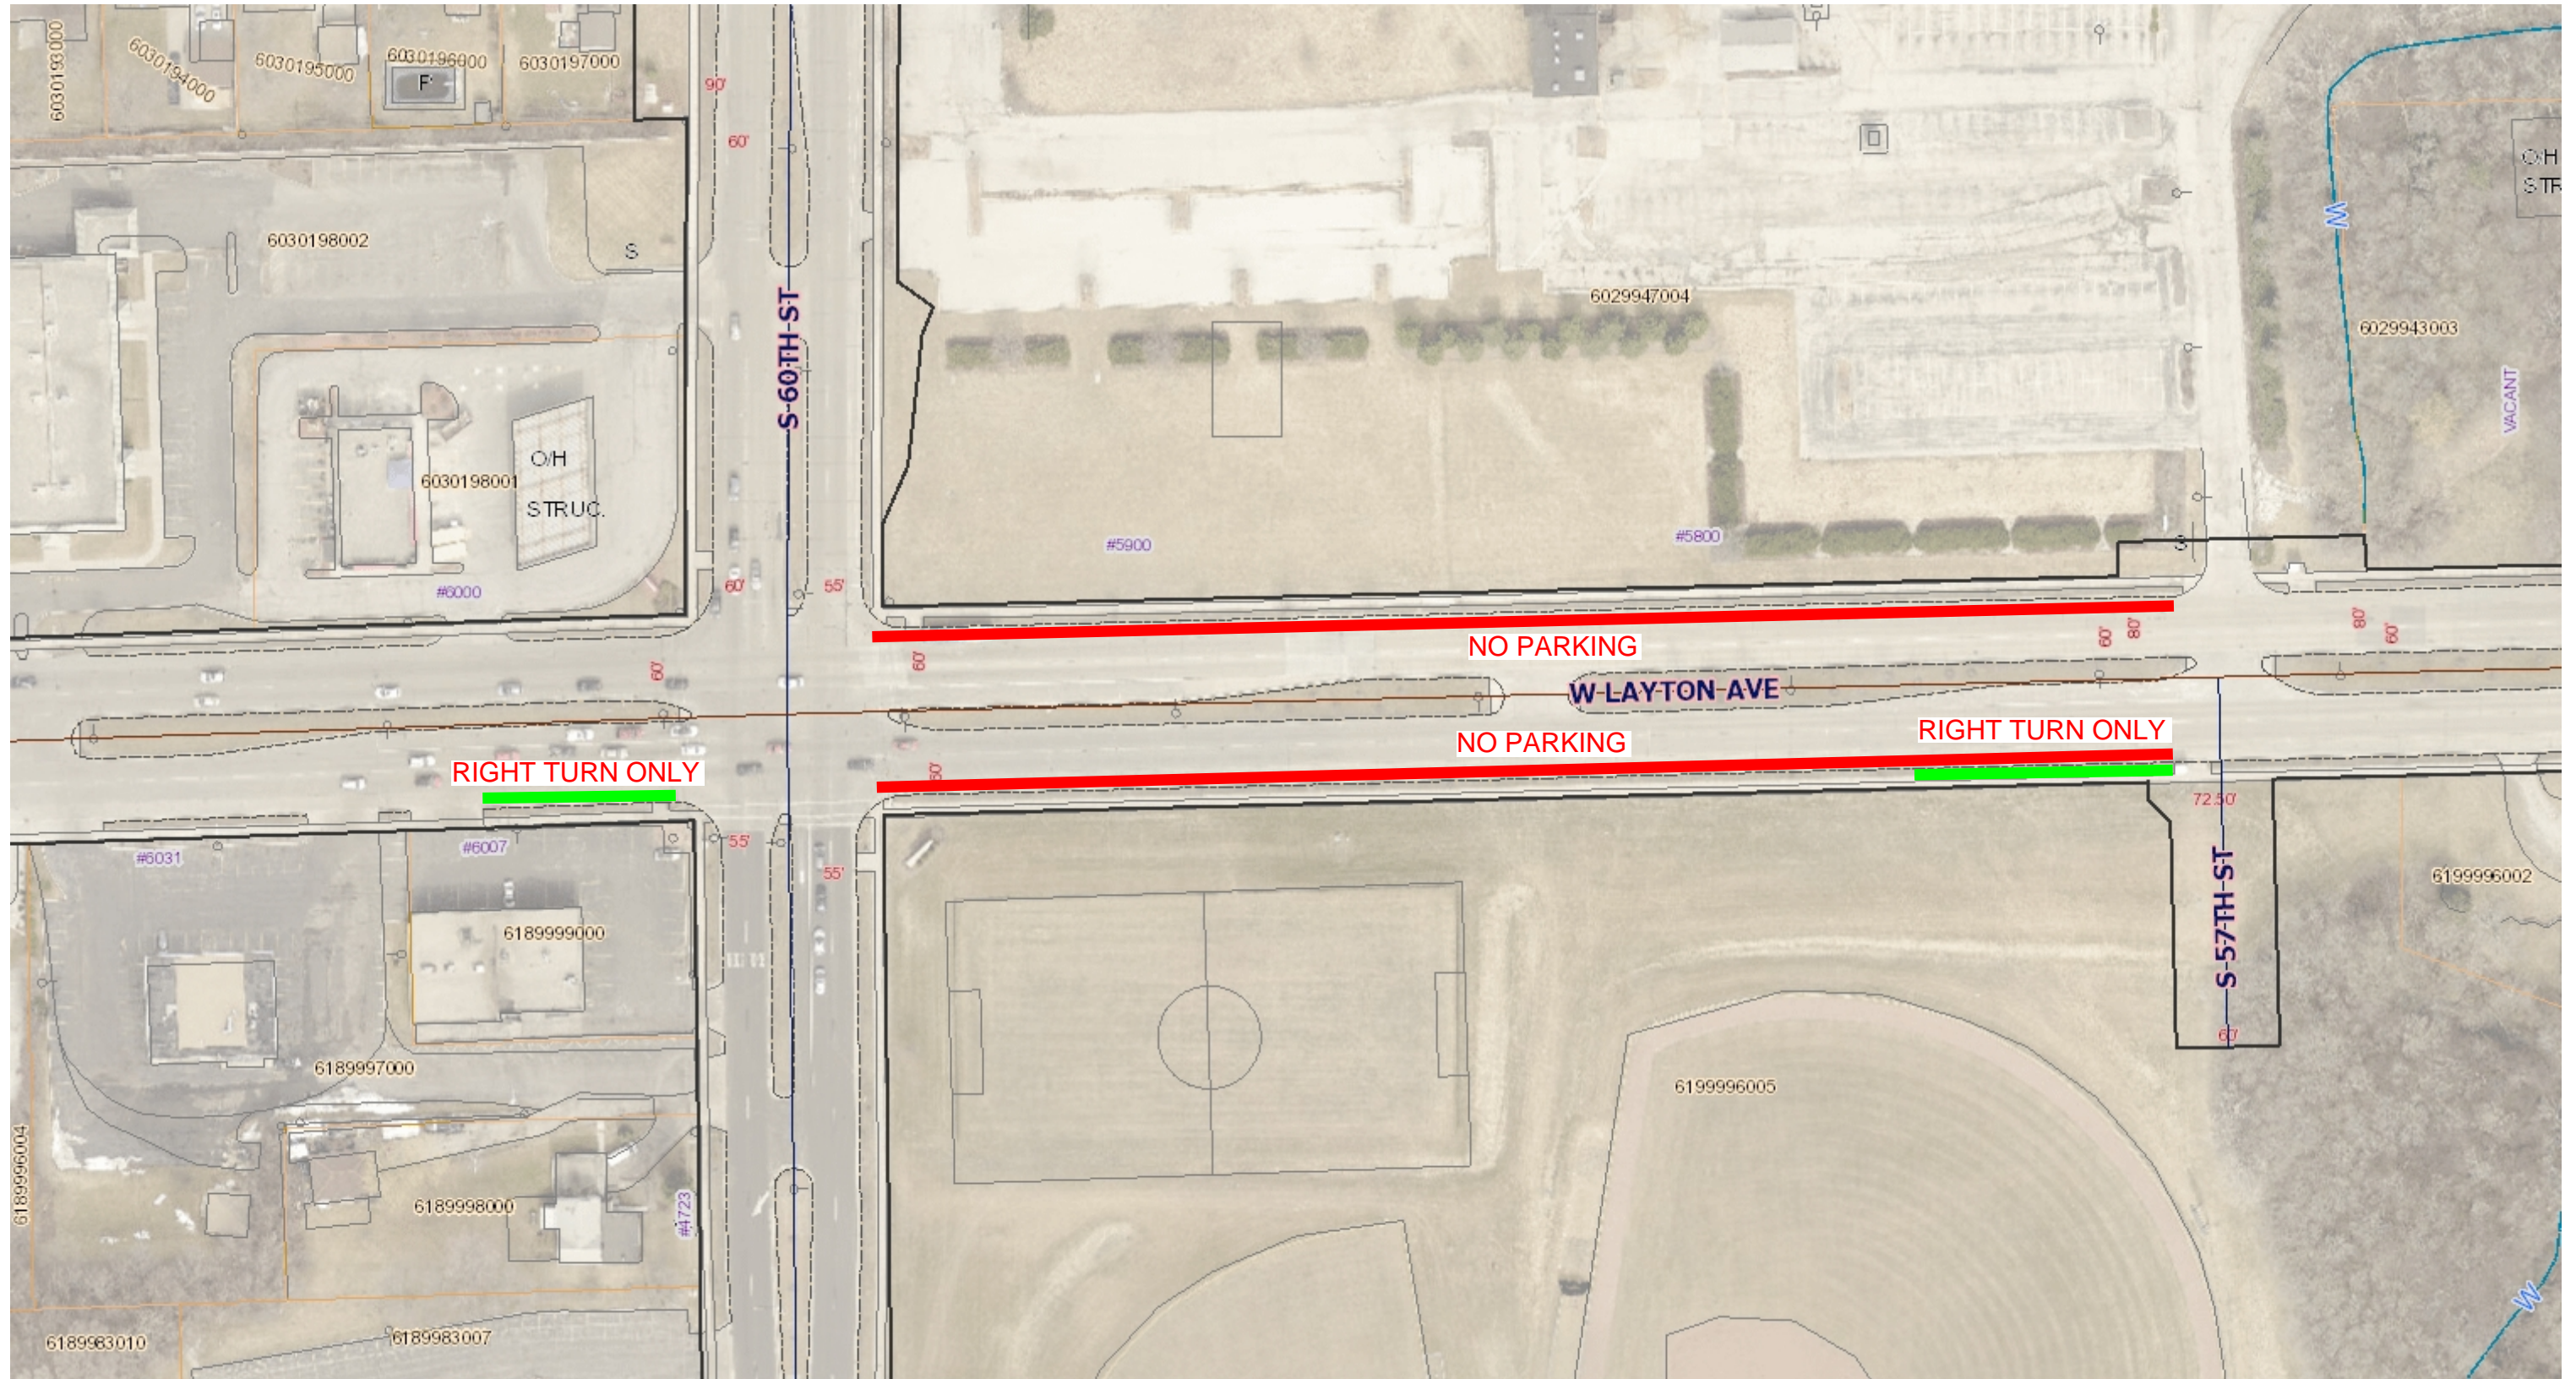

City of Greenfield GIS

DISCLAIMER: The City of Greenfield does not guarantee the accuracy of the material contained here in and is not responsible for any misuse or misrepresentation of this information or its derivatives. Greenfield GIS map data is for tax and real property listing purposes and does not represent a plat of survey.



SCALE: 1" = 94'

City of Greenfield
7325 West Forest Home Ave.
Greenfield, WI 53220

Print Date: 4/24/2017