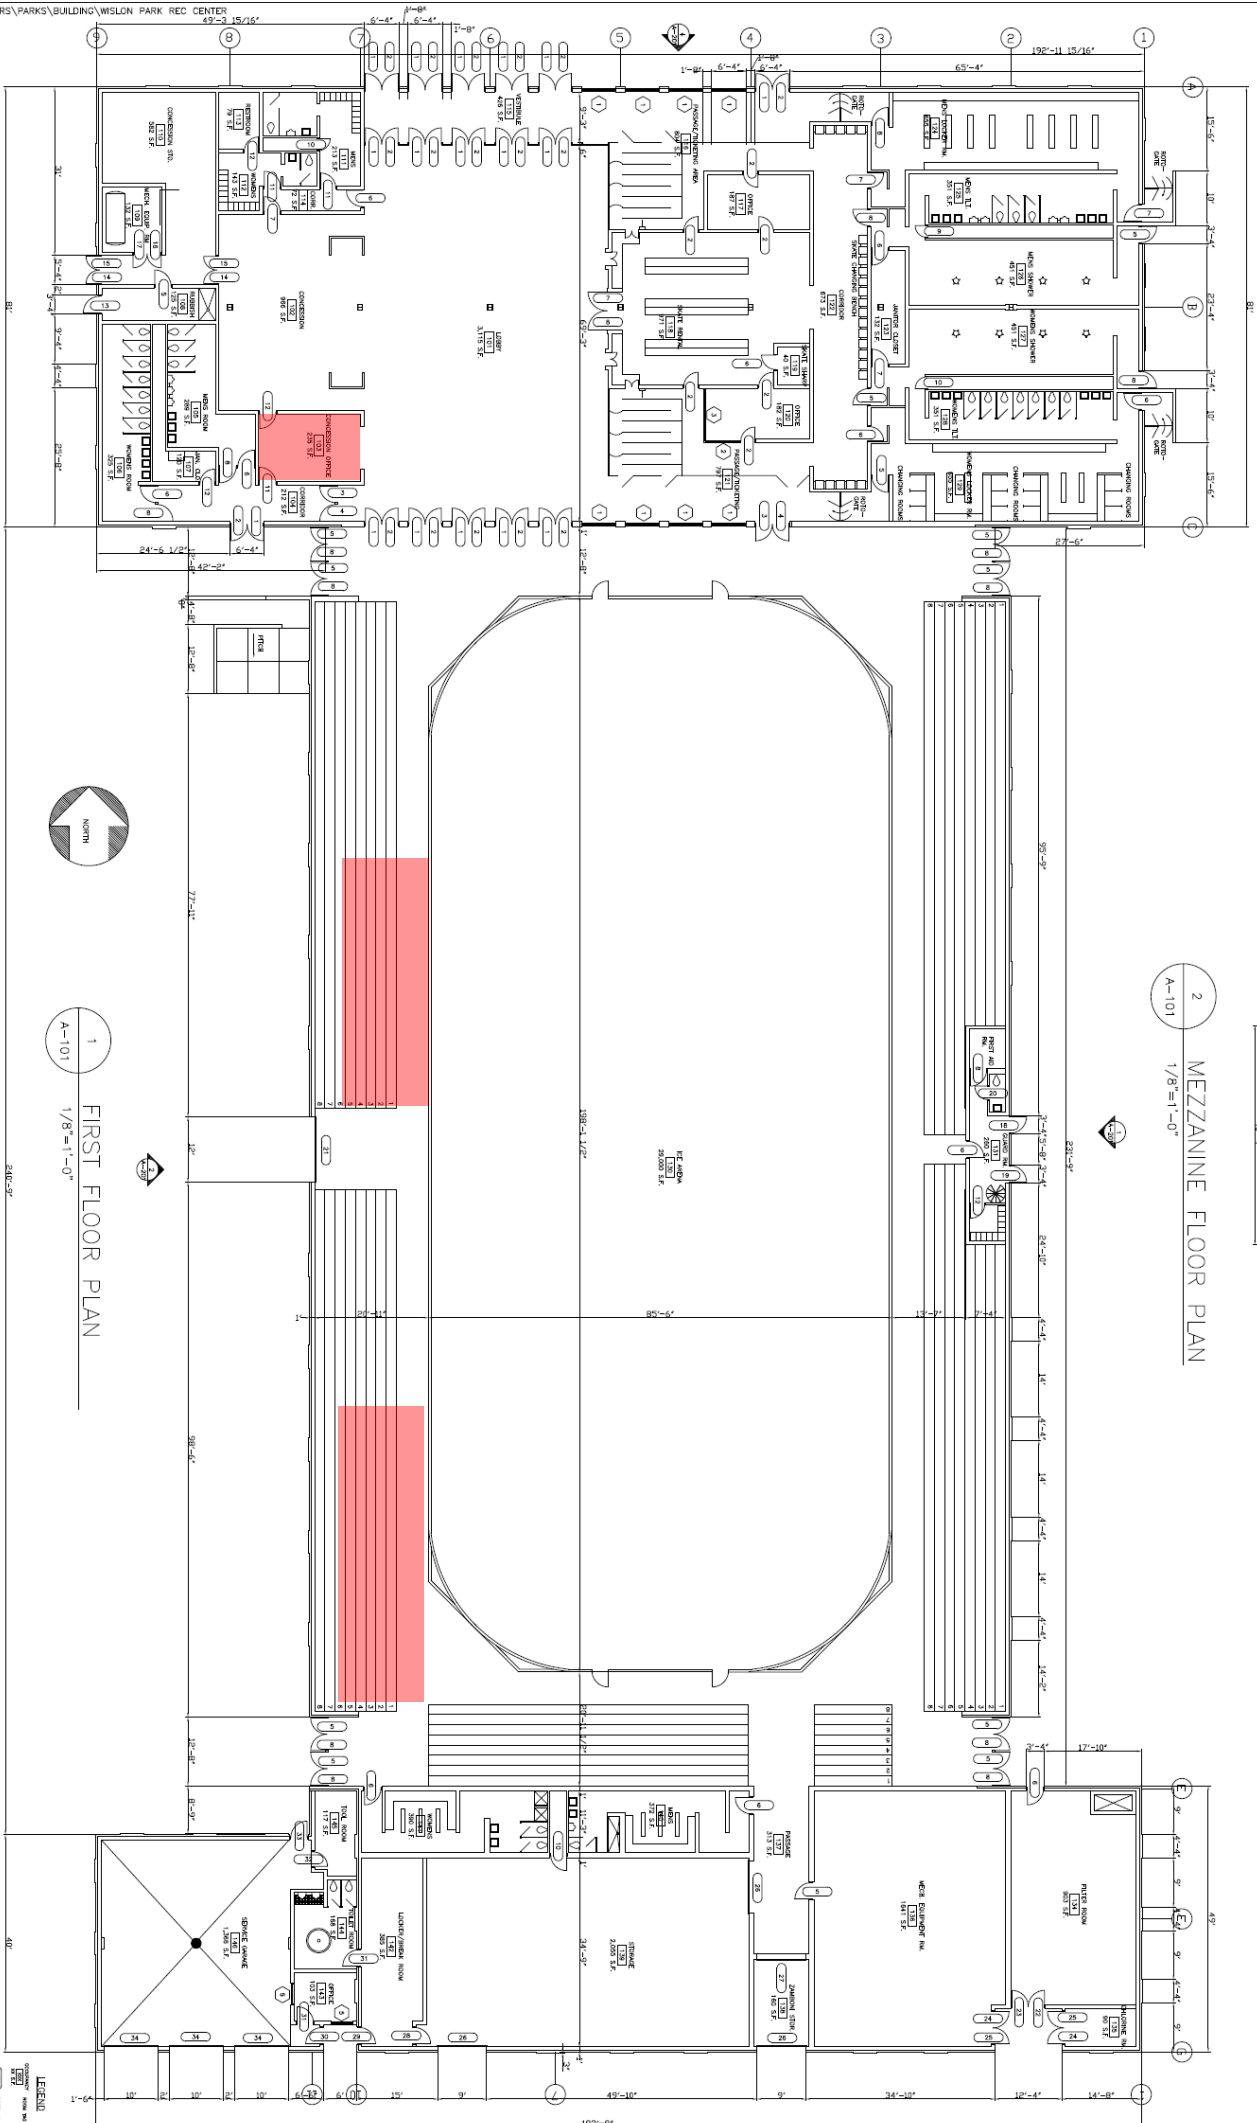


2 MEZZANINE FLOOR PLAN
A-101 1/8"=1'-0"

1 FIRST FLOOR PLAN
A-101 1/8"=1'-0"

SHEET NO. A-101 FILE NO. A-101-DES	PROJECT NO. 3860	PROJECT TITLE MILWAUKEE COUNTY PARKS WILSON PARK REC CENTER SHEET DESCRIPTION: FLOOR PLAN	SCALE: 1/8"=1'-0" DATE: APRIL 1, 2000	DRAWN BY: AMF CHECKED BY: ESR	REVISIONS: RECORD DRAWINGS	MILWAUKEE COUNTY DEPARTMENT OF PUBLIC WORKS ARCHITECTURE AND ENGINEERING DIVISION COURTHOUSE ANNEX 907 NORTH 10TH STREET MILWAUKEE, WISCONSIN 53233
--	---------------------	--	--	--	----------------------------------	---